



TOWNSHIP No. X RANGE No. VI.

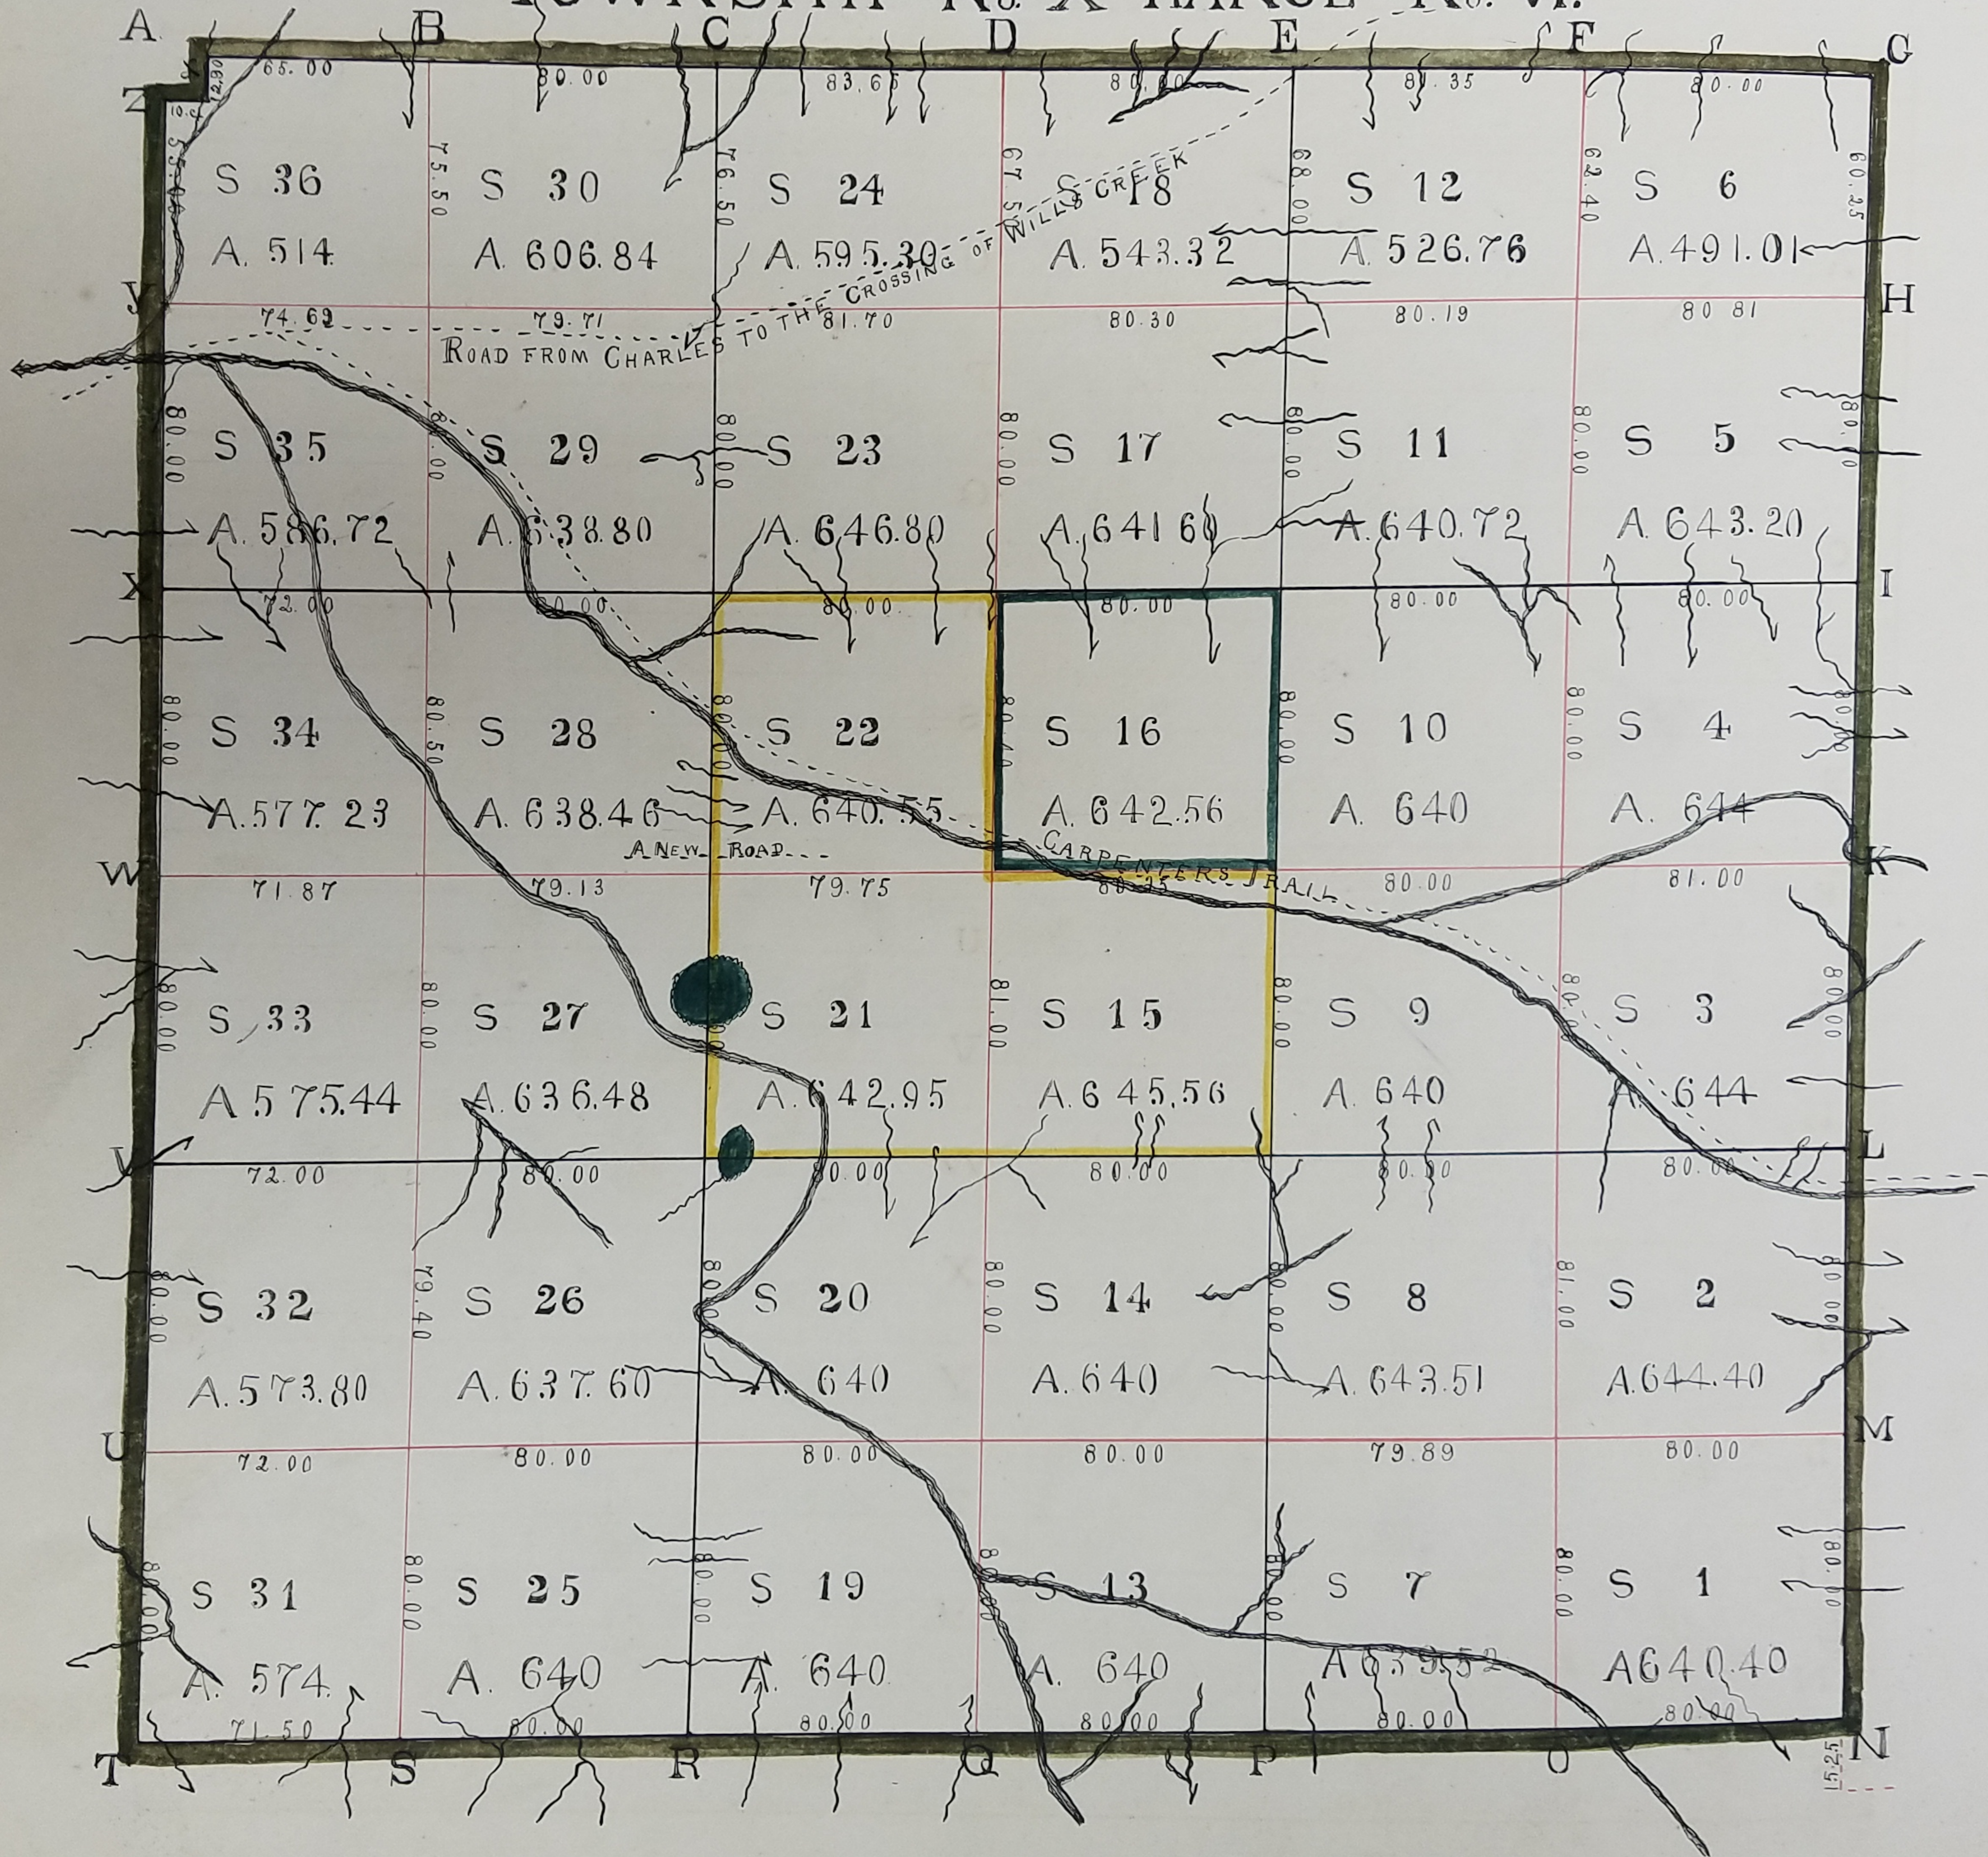

A TRUE COPY
 DAVID HOGE REG.

A TRUE COPY
 BY
 JOHN A BOND
 1894

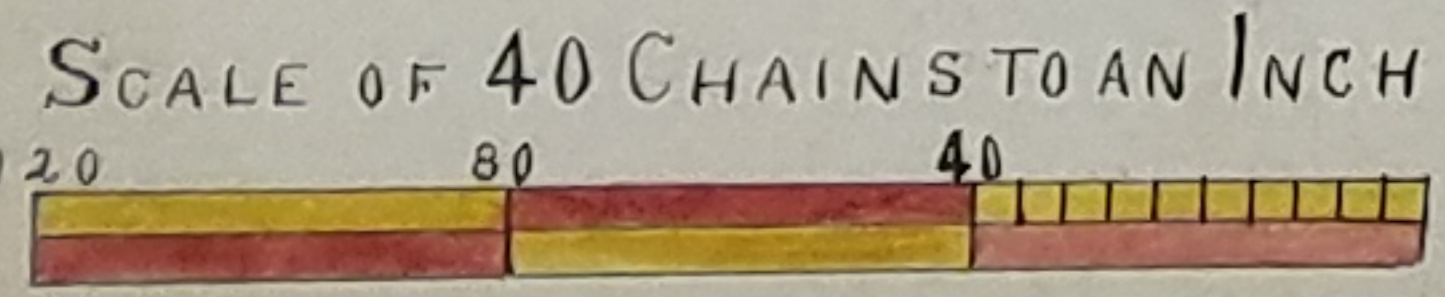

DESCRIPTION OF TOWNSHIP No. X RANGE No. VI.

POSTS	BEARING TREES	INCHES DIAM.	COURSE THEY BEAR	LINKS DISTANT	POSTS	BEARING TREES	INCHES DIAM.	COURSE THEY BEAR	LINKS DISTANT
A	HICKORY	08	CORNER	TREE	O	SUGARTREE	13	N 64 W	24
	W. OAK	17	N 18 E	69		DO	13	S 16 E	48
	DO	38	S 56 W	68	P	MAPLE	08	N 70 E	22½
B	B. OAK	15	S 19 W	20		HICKORY	14	S 84 W	33
	W. OAK	14	N 22 E	65	Q	BEECH	06	N 76 W	10
C	DO	17	WEST	16		MAPLE	09	S 76 E	09
	DO	17	S 75 E	25	R	B. OAK	10	S 84 E	20
D	DO	12	S 6½ E	12½		DO	10	N 55 W	27
	HICKORY	08	N 15 W	13	S	W. OAK	13	N 19 W	24
E	W. OAK	10	N 54½ E	25		DO	12	S 39½ E	17
	DO	10	S 72 W	13	T	POPLAR	40	N 76 E	16½
F	B. OAK	22	EAST	11		SUGARTREE	08	S 74 W	50
	DO	18	S 28 W	20½	U	HICKORY	10	N 45½ W	17
G	W. OAK	13	S 85½ W	21		B. OAK	20	S 37 E	25
	GUM	12	S 15½ E	38	V	W. OAK	06	N 7 E	09
H	W. OAK	34	S 29 E	29		DO	12	S 1 E	53
	DO	28	N 46 W	56	W	POPLAR	07	N 37 W	23
I	DO	22	N 14 E	36½		CHESTNUT	05	S 7 E	07
	DO	13	S 79½ W	29	X	DO	10	N 51 E	16
K	ELM	13	SOUTH	27		HICKORY	10	S 8½ E	24
	W. OAK	14	N 19½ W	22	Y	W. OAK	35	S 55 E	11
L	HICKORY	14	S 88 W	27		DO	12	N 24 E	32
	W. OAK	18	S 54½ E	62	Z	DO	14	N 1 W	53
M	HICKORY	12	N 35 W	35		ELM	17	N 16 E	48
	DO	14	S 45 W	20	aa	W. OAK	15	S 74 W	33½
N	BEARING TREES	MARKED BUT NOT				DO	14	S 89 E	66
	NOTED IN G.	BOOK							

RED-LINES
TOWNSHIP No. X RANGE No. VI CONTINUED
QUARTER SECTION POSTS DESCRIBED.

QUARTER POSTS	BEARING TREES	INCHES DIAM.	COURSE THEY BEAR	LINKS DISTANT	QUARTER SECTION	BEARING TREES	INCHES DIAM.	COURSE THEY BEAR	LINKS DISTANT	QUARTER SECTION	BEARING TREES	INCHES DIAM.	COURSE THEY BEAR	LINKS DISTANT
BETWEEN SECTIONS 1 & 2	W. OAK	30	N 26 W	13	BETWEEN SECTIONS 5 & 6	HICKORY	14	S 24 E	30	BETWEEN SECTIONS 13 & 19	W. OAK	11	S 42 E	05
	DO	11	S 26 E	36		DO	12	N 35 W	26		BEECH	04	N 89 W	40
7 & 8	B. OAK	15	N 44 W	21	11 & 12	DO	12	N 45 W	13	14 & 20	POPLAR	07	S 57 E	27
	HICKORY	06	S 54 E	34		W. OAK	30	S 45 E	26		DO	08	N 86 W	17
13 & 14	SARVISTREE	06	N 44 E	06	17 & 18	B. OAK	24	N 70 E	05	15 & 21	BEECH	06	N 19 W	25
	SUGARTREE	08	S 51 W	39		W. OAK	30	S 40 W	80		DO	10	S 38 E	15
19 & 20	B. ASH	11	N 52 E	22	23 & 24	DO	18	S 5 E	19	16 & 22	W. OAK	20	N 82 W	26
	DO	14	S 31 W	33		DO	15	N 5 W	33		DO	13	N 80 E	30
25 & 26	W. OAK	28	S 40 E	33	29 & 30	DO	08	S 68 W	24	17 & 23	DO	15	S 75 W	08
	GUM	06	N 29 W	07		DO	06	N 69 E	25		B. OAK	12	N 58 E	24
31 & 32	W. OAK	13	N 65 W	25	35 & 36	DO	14	S 37 W	14	18 & 24	IRONWOOD	08	N 28 E	18
	DO	17	S 21 E	13		DO	18	N 36 E	46		HICKORY	06	S 42 W	10
3 & 4	DO	18	N 51 W	38	1 & 7	GUM	06	S 27 W	13	25 & 31	W. OAK	10	N 54 W	25
	HICKORY	12	S 45 E	30		DOGWOOD	06	N 54 E	33		DO	18	S 84 E	14
9 & 10	B. OAK	12	S 31 E	10	2 & 8	GUM	06	S 5 E	13	26 & 32	POPLAR	09	N 79 W	10
	W. OAK	20	N 31 W	12		DO	04	N 19 W	05		DOGWOOD	04	S 80 E	10
15 & 16	B. ASH	14	S 68 E	06	3 & 9	W. OAK	14	N 49 E	31	27 & 33	BEECH	10	N 43 W	13
	DO	10	N 73 W	36		HICKORY	04	S 46 W	05		MAPLE	05	SOUTH	16
21 & 22	W. OAK	18	N 39 W	57	4 & 10	W. OAK	11	S 31 E	16	28 & 34	BEECH	09	S 42 E	23
	DO	17	S 70 E	06		HICKORY	05	N 59 W	10		W. OAK	23	N 43 W	29
27 & 28	DO	14	S 25 W	62	5 & 11	SUGARTREE	08	N 63 E	18	29 & 35	BEECH	11	N 48 E	13
	DO	24	N 25 E	05		W. ASH	04	S 15 W	15		W. OAK	09	S 48 W	11
33 & 34	ELM	08	S 48 E	19	6 & 12	IRONWOOD	04	S 77 W	08	30 & 36	ELM	06	N 29 W	20
	BEECH	06	N 55 W	32		SASSAFRAS	04	N 77 E	07		DO	10	S 83 W	26

TOWNSHIP No X RANGE No. VI CONTINUED INTERIOR SECTION CORNERS BLACK-LINES.

SECTION CORNERS	BEARING TREES	INCHES DIAM.	COURSE THEY BEAR	LINKS DISTANT	SECTION CORNERS	BEARING TREES	INCHES DIAM.	COURSE THEY BEAR	LINKS DISTANT
7 8 13 14	HICKORY	11	S 7 W	30	20 21 26 27	SUGARTREE	10	S 14 W	22
	W. OAK	10	N 60 W	03 1/2		W. OAK	13	S 66 E	25
8 9 14 15	DO	13	S 81 E	52	14 15 20 21	SUGARTREE	10	S 84 E	27
	DO	12	S 81 W	18		W. OAK	10	N 84 W	28
2 3 8 9	DO	10	N 2 W	49	26 27 32 33	DO	30	N 88 E	20
	DO	13	S 16 W	23		DO	13	S 74 1/2 W	44
9 10 15 16	IRONWOOD	07	CORNER	TREE	21 22 27 28	DO	15	CORNER	TREE
	HICKORY	12	N 5 W	60		B. OAK	17	S 81 E	31
	DO	16	S 83 E	47		W. OAK	13	S 64 W	43
10 11 16 17	W. OAK	17	S 7 E	13	22 23 28 29	DO	10	S 53 W	07
	B. OAK	22	N 47 W	11		B. OAK	16	N 10 1/2 W	18 1/2
11 12 17 18	HICKORY	10	S 17 E	38	16 17 22 23	W. OAK	10	N 76 E	38
	B. OAK	17	S 76 W	16		DO	09	S 48 E	40
4 5 10 11	W. OAK	16	N 45 E	33	23 24 29 30	B. OAK	15	S 43 W	07 1/2
	BEECH	10	S 46 E	21		FLM	07	S 89 E	25 1/2
19 20 25 26	W. OAK	38	S 57 E	17	28 29 34 35	MAPLE	08	N 81 E	17
	DO	18	N 42 W	61		W. OAK	15	S 8 1/2 E	39

INTERIOR SECTION CORNERS RED-LINES

SECTION CORNERS	BEARING TREES	INCHES DIAM.	COURSE THEY BEAR	LINKS DISTANT	SECTION CORNERS	BEARING TREES	INCHES DIAM.	COURSE THEY BEAR	LINKS DISTANT
1 2 7 8	HICKORY	12	N 23 W	37	17 18 23 24	HICKORY	10	S 41 W	14
	IRONWOOD	04	S 16 E	16		POPLAR	06	N 37 E	15
3 4 9 10	SUGARTREE	06	N 65 E	26	25 26 31 32	DO	14	S 85 E	07
	W. ASH	13	S 54 W	43		B. OAK	24	N 78 W	29
5 6 11 12	GUM	08	N 58 W	10	27 28 33 34	W. OAK	40	N 63 W	42
	MAPLE	07	S 58 E	08		W. ASH	05	S 77 E	15
13 14 19 20	BEECH	05	S 67 W	19	29 30 35 36	B. OAK	16	S 38 W	15
	SUGARTREE	05	N 52 E	09		DOGWOOD	06	N 38 E	04
15 16 21 22	B. ASH	05	N 26 W	15					
	MAPLE	05	S 36 E	12					

A-TRUE COPY
DAVID HOCE REG.

A-TRUE COPY
BY
JOHN A. BOND
1894